

**BASIS OF BEARINGS NOTE:**  
BASIS OF BEARINGS IS THE SOUTH LINE OF THE SE 1/4 OF SECTION 9, T2S, R1W, U.S.B.&M. WHICH IS TAKEN FROM GLOBAL POSITIONING SATELLITE OBSERVATIONS TO BEAR N89°05'59"E A MEASURED DISTANCE OF 2639.30' (THE SOUTHEAST CORNER OF SECTION 9, BEING A 2" ALUMINUM CAP AND THE SOUTH 1/4 OF SECTION 9, BEING A 2" ALUMINUM CAP).

RIGHT-OF-WAY LENGTHS		
OWNERSHIP	FEET	RODS
COUNTY RIGHT-OF-WAY (LOT 9)	82.61'	5.0

#### PIPELINE RIGHT-OF-WAY DESCRIPTION

BEGINNING AT A POINT ON THE SOUTH LINE OF LOT 9 OF COTTONWOOD CREEK ESTATES NO. 3 IN SECTION 9, T2S, R1W, U.S.B.&M. WHICH BEARS N48°59'09"W 991.75' FROM THE SOUTH 1/4 CORNER OF SAID SECTION 9, THENCE N24°25'22"W 11.22'; THENCE N22°50'34"W 40.22'; THENCE N27°05'41"W 31.17' TO A POINT ON THE WEST LINE OF SAID LOT 9 WHICH BEARS N47°09'37"W 1067.52' FROM THE SAID SOUTH 1/4 CORNER OF SECTION 9. THE SIDE LINES OF SAID DESCRIBED RIGHT-OF-WAY BEING SHORTENED OR ELONGATED TO MEET THE GRANTOR'S PROPERTY LINES. BASIS OF BEARINGS IS THE SOUTH LINE OF THE SE 1/4 OF SECTION 9, T2S, R1W, U.S.B.&M. WHICH IS TAKEN FROM GLOBAL POSITIONING SATELLITE OBSERVATIONS TO BEAR N89°05'59"E A MEASURED DISTANCE OF 2639.30'.

**CORNER TIE NOTE:**  
End P.O.P.L. 21+60.02  
bears N47°09'37"W 1067.52'  
from the South 1/4 Corner  
of Section 9.

V. Dann  
Lot 9 Cottonwood  
Creek Estates No. 3

**END OF AS-BUILT  
PIPELINE RIGHT-OF-WAY  
P.O.P.L. 21+60.02  
(At Property Line)**

**BEGINNING OF AS-BUILT  
PIPELINE RIGHT-OF-WAY  
P.O.P.L. 20+77.41  
(At Property Line)**

**CORNER TIE NOTE:**  
Beginning P.O.P.L. 20+77.41  
bears N48°59'09"W 991.75'  
from the South 1/4 Corner  
of Section 9.


#### KINDER MORGAN ALTAMONT LLC.

#### AS-BUILT PIPELINE RIGHT-OF-WAY ON DUCHESNE COUNTY ROAD 81 RIGHT-OF-WAY

(FEE GAP #18G)

Located in the SE 1/4 SW 1/4 of  
Section 9, T2S, R1W, U.S.B.&M.  
Duchesne County, Utah

#### EXHIBIT A

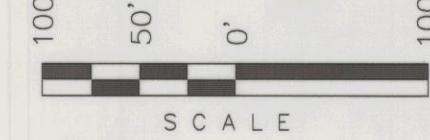

#### LEGEND

P.I. = POINT OF INTERSECTION  
P.O.P.L. = POINT ON PROPERTY LINE  
--- = PROPERTY LINE

#### CERTIFICATE

THIS IS TO CERTIFY THAT THE ABOVE PLAT WAS PREPARED FROM FIELD NOTES AND SURVEYS MADE BY ME OR UNDER MY SUPERVISION, THAT THE SAME ARE TRUE AND CORRECT TO THE BEST OF MY KNOWLEDGE AND BELIEF.

PAUL A. HAWKES  
REGISTERED LAND SURVEYOR  
REGISTRATION NO. 348473  
STATE OF UTAH

SURVEYED BY: C.D.S.

DRAWN BY: L.K.

DATE: 10-24-13


SCALE: 1" = 100'

DWG #: 13-0324

**Tri State**  
Land Surveying, Inc.

(435) 781-2501

180 NORTH VERNAL AVE. - VERNAL, UTAH 84078

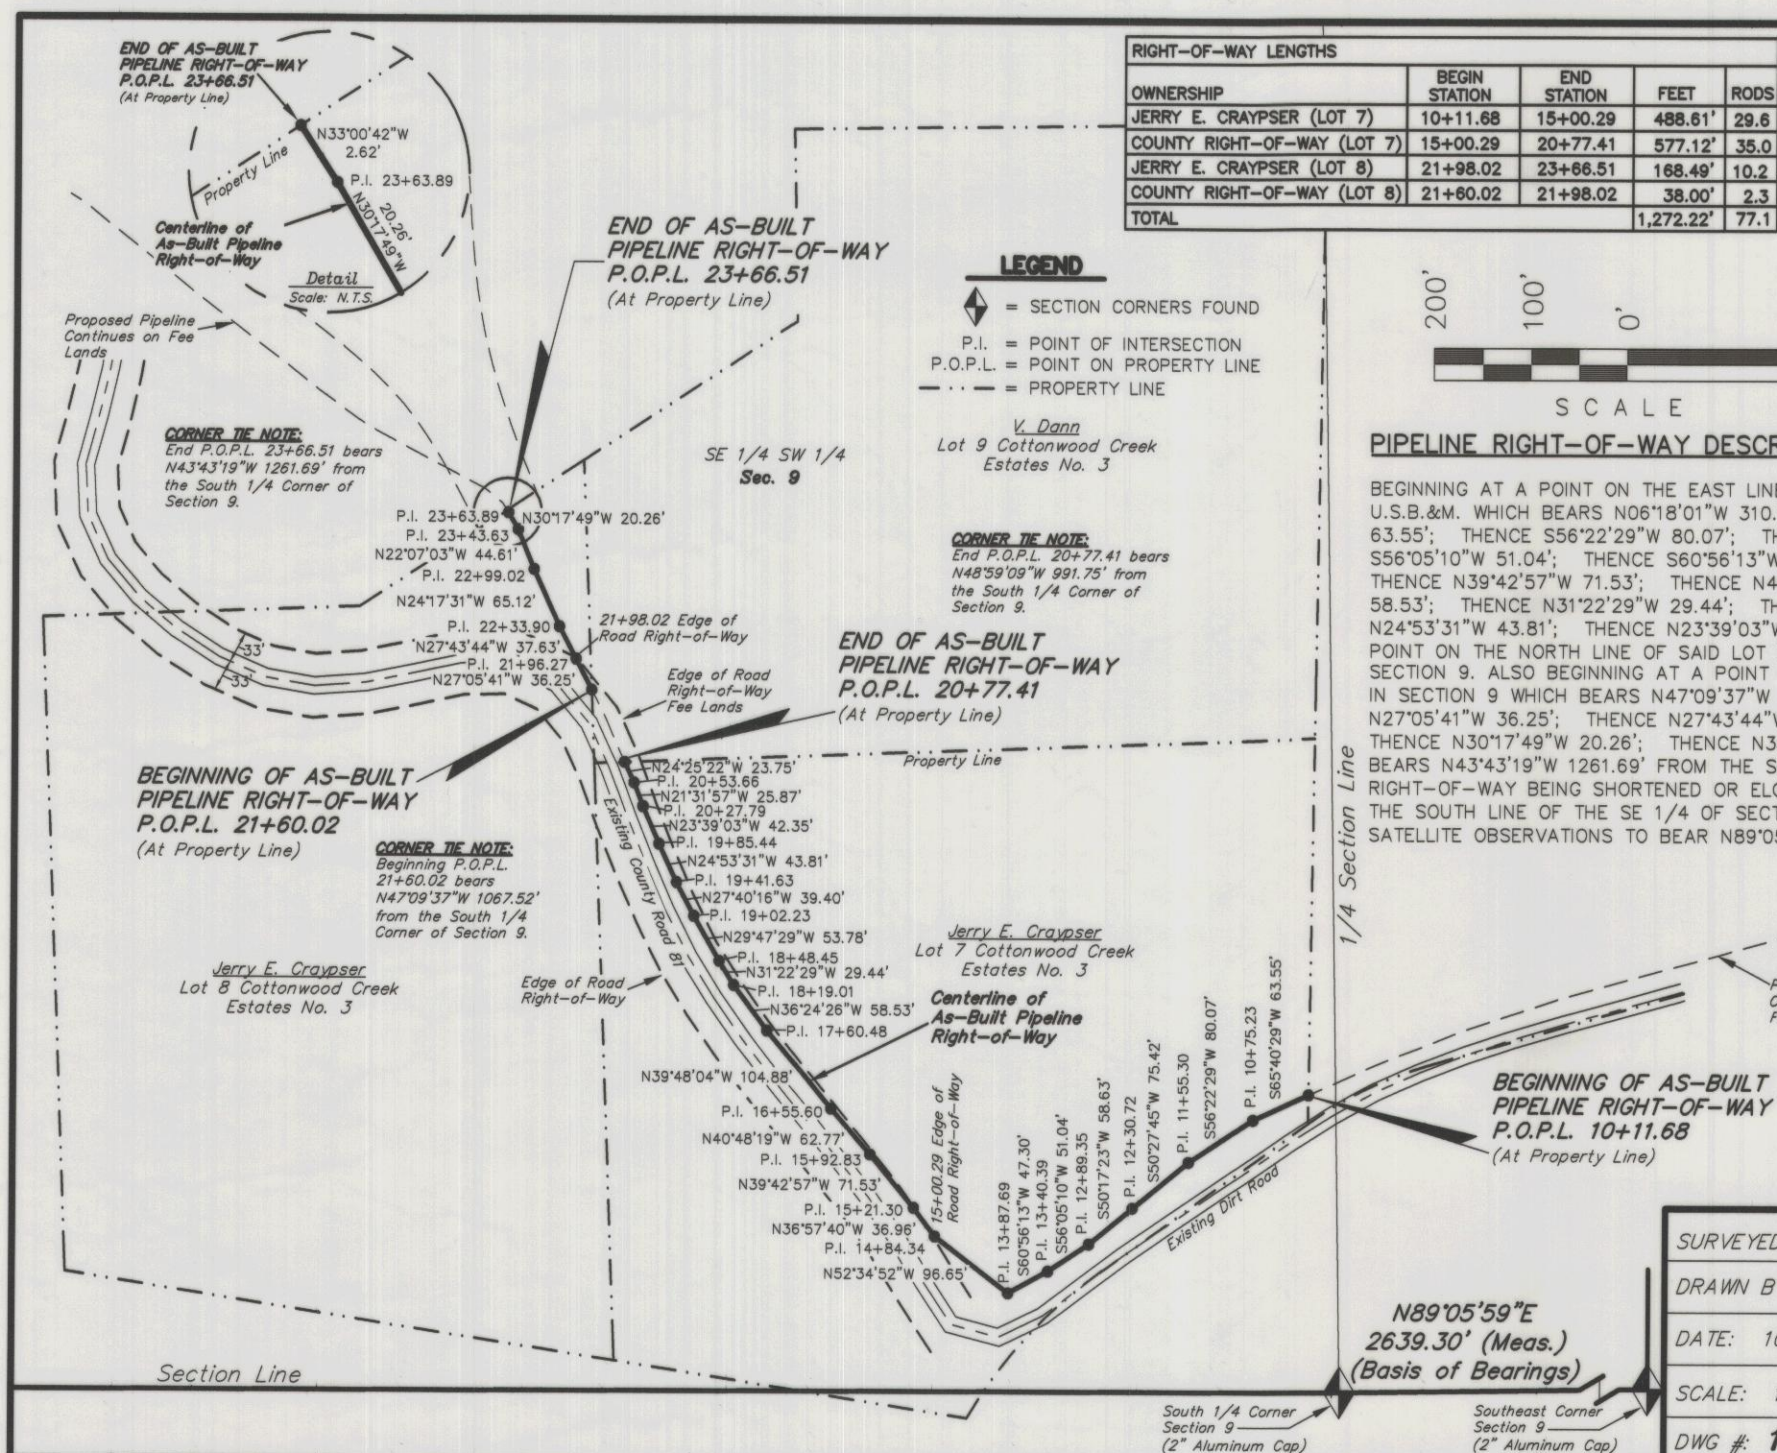

#### KINDER MORGAN ALTAMONT LLC.

#### AS-BUILT PIPELINE RIGHT-OF-WAY ON JERRY E. CRAWPSER

(FEE GAP #18H)

Located in the SE 1/4 SW 1/4 of  
Section 9, T2S, R1W, U.S.B.&M.  
Duchesne County, Utah

#### EXHIBIT A

#### PIPELINE RIGHT-OF-WAY DESCRIPTION

BEGINNING AT A POINT ON THE EAST LINE OF LOT 7 OF COTTONWOOD CREEK ESTATES NO. 3 IN SECTION 9, T2S, R1W, U.S.B.&M. WHICH BEARS N06°18'01"W 310.75' FROM THE SOUTH 1/4 CORNER OF SAID SECTION 9, THENCE S65°40'29"W 63.55'; THENCE S56°22'29"W 80.07'; THENCE S50°27'45"W 75.42'; THENCE S50°17'23"W 58.63'; THENCE S56°05'10"W 51.04'; THENCE S60°56'13"W 47.30'; THENCE N52°34'52"W 96.65'; THENCE N36°57'40"W 36.96'; THENCE N39°42'57"W 71.53'; THENCE N40°48'19"W 62.77'; THENCE N39°48'04"W 104.88'; THENCE N36°24'26"W 58.53'; THENCE N31°22'29"W 29.44'; THENCE N29°47'29"W 53.78'; THENCE N27°40'16"W 39.40'; THENCE N24°53'31"W 43.81'; THENCE N23°39'03"W 42.35'; THENCE N21°31'57"W 25.87'; THENCE N24°25'22"W 23.75' TO A POINT ON THE NORTH LINE OF SAID LOT 7 WHICH BEARS N48°59'09"W 991.75' FROM THE SAID SOUTH 1/4 CORNER OF SECTION 9. ALSO BEGINNING AT A POINT ON THE EAST LINE OF LOT 8 OF SAID COTTONWOOD CREEK ESTATES NO. 3 IN SECTION 9 WHICH BEARS N47°09'37"W 1067.52' FROM THE SAID SOUTH 1/4 CORNER OF SECTION 9, THENCE N27°05'41"W 36.25'; THENCE N27°43'44"W 37.63'; THENCE N24°17'31"W 65.12'; THENCE N22°07'03"W 44.61'; THENCE N30°17'49"W 20.26'; THENCE N33°00'42"W 2.62' TO A POINT ON THE NORTH LINE OF SAID LOT 8 WHICH BEARS N43°43'19"W 1261.69' FROM THE SAID SOUTH 1/4 CORNER OF SECTION 9. THE SIDE LINES OF SAID DESCRIBED RIGHT-OF-WAY BEING SHORTENED OR ELONGATED TO MEET THE GRANTOR'S PROPERTY LINES. BASIS OF BEARINGS IS THE SOUTH LINE OF THE SE 1/4 OF SECTION 9, T2S, R1W, U.S.B.&M. WHICH IS TAKEN FROM GLOBAL POSITIONING SATELLITE OBSERVATIONS TO BEAR N89°05'59"E A MEASURED DISTANCE OF 2639.30'.

#### CERTIFICATE

THIS IS TO CERTIFY THAT THE ABOVE PLAT WAS PREPARED FROM FIELD NOTES AND SURVEYS MADE BY ME OR UNDER MY SUPERVISION, THAT THE SAME ARE TRUE AND CORRECT TO THE BEST OF MY KNOWLEDGE AND BELIEF.

PAUL A. HAWKES  
REGISTERED LAND SURVEYOR  
REGISTRATION NO. 348473  
STATE OF UTAH

SURVEYED BY: C.D.S.

DRAWN BY: L.K.

DATE: 10-23-13

SCALE: 1" = 200'

DWG #: 13-0323

**Tri State**  
Land Surveying, Inc.

(435) 781-2501

180 NORTH VERNAL AVE. - VERNAL, UTAH 84078